

LIST  
WIRING

A3P

PLUG TO PLUG

REV. 7-MD. 1-6-67  
 REV. A - 11-7-61  
 REV. B - 11-8-61  
 REV. C - 2-1-62  
 REV. D - 5-8-62  
 REV. 5-7-9-63  
 REV. 6-8-8-67  
 A-491870A

Add. Dwg. # 4918-5 revised to series 801 with Prime Sky connectors.  
 This sheet same on series 800 Back Plate.

REF D-365376  
 WIRING DIAGRAM -  
 SHEET 2  
 DO NOT  
 USE FOR  
 DESIGN  
 AFTER  
 12/80  
 2/19/81

CONTRACT NO	COLOR	WIRE NO.	TO PLUGS	CONTACT NO.
1	GRN/W		19	5
2	WHT		2	2
3	BLK		2	14
4	GRAY		2	15
5	BLUE		19	16
6	WHITE		2, 7	19
7	YELLOW		2	18
1	PLUG 0			
2	RED/W			
3				
4				
5	WHITE			
6				
7				
8				

POINTER  
 POINTER 6V COMM  
 IN USE 120V  
 CARDINAL POINTS  
 BLUE LAMPS  
 L2  
 AMBER LAMPS  
 CARDINAL POINTS


19  
 2  
 2  
 14  
 15  
 19  
 16  
 2, 7  
 2

WIRE LIST

SHEET NO. 1 OF 1  
 SUBJECT: A-3P WIRING  
 POINT PLUG #1  
 A-491870A  
 DATE: \_\_\_\_\_  
 BY: \_\_\_\_\_  
 DATE: \_\_\_\_\_  
 CHKD. BY: \_\_\_\_\_

BY \_\_\_\_\_ DATE \_\_\_\_\_  
 CHKD. BY \_\_\_\_\_ DATE \_\_\_\_\_  
 SUBJECT: A-3P WIRING  
PANEL "B"  
~~# 491870~~ 491870  
 SHEET NO. \_\_\_\_\_ OF \_\_\_\_\_  
 JOB NO. \_\_\_\_\_  
PLUG # 2

CONTACT NO.	CABLE COLOR	WIRE NO.	PLUG TO CONTACT	PLUG NO.	REMARKS
1	RED	L1			
2	WHITE	L2			
3	BLACK	6V. UNREG			
4	GRN/W	READING LIGHT	20	1	
5	GRN/W				
6					
7					
8					
9	VIO	SW6	5	7	CONSTELLATION #1
10	GRN	SW7	5	8	" #2
11	BLU	SW8	5	9	AURORA
12	YEL	SW9	5	11	AUX
13					
14	BLK/W		1	3	
15	GRAY		1	4	
16	ORN.				
17	ORN/W				
18	TAN				
19	RED/W				
20					
21	VIO/W	SW6	5	16	CONSTELLATION #3
22	GRN/W	SW7	5	17	" #4
23	BLU/W	SW8	5	10	AURORA
24	YEL/W	SW9	5	20	AUX

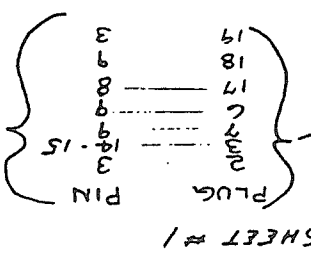

Add. Dwg. No. 4918-5 revised to series 801 with Prime Sky connectors.  
 This sheet same on series 800 Back Plate.

REV. A-11-7-61  
 REV. B-11-8-61  
 REV. C-2-1-62  
 REV. D-5-8-62  
 REV. E-7-9-63  
 REV. F-8-8-64  
 H-491870A



BY \_\_\_\_\_ DATE \_\_\_\_\_  
 SUBJECT A3P WIRING  
 D.M. & L.A.T.  
 POWER & SPEED CONTROL  
 JOB NO. \_\_\_\_\_  
 SHEET NO. \_\_\_\_\_ OF \_\_\_\_\_  
 PLUG 4

1	WHITE	GROUND	1-9	3 PINS
2	RED	L1		
3	GREEN	D.M. BASE	18	2
4	BROWN	D.M. SWITCH BOV.	18	3
5	ORANGE	D.M. EMITER	18	4
6	TAN	L.A.T. BASE	15	2
7	YELLOW	L.A.T. SWITCH BOV.	15	3
8	PINK	L.A.T. EMITER	15	4
9	GRAY	GROUND (1-9)		
10	BLACK			
11				
12	BLUE	D.M. FIELD (4-12)	8	20
13				
14				
15	VIOLET	L.A.T. FIELD (7-15)	6	20
16		L.A.T. FIELD		

Add. Dwg. No. 4918-5 revised to series 801 with Prime Sky connectors.  
 This sheet same on series 800 Back Plate.

400C AH SYSTEM  
 100C D.M. SYSTEM  
 REV D - 4-2-62  
 REV G - 10-2-62  
 REV Z - 8-8-62  
 A-491870A

A-49187D

REV. A - 11-7-61  
 REV. B - 11-8-61  
 REV. C - 2-1-62  
 REV. 5, 7-9-63  
 REV. 6, 9-8-66

ADD. DWG. # 4918-5 REVISED TO SERIES 801 WITH PRIME SKY CONNECTORS.  
 THIS SHEET SAME ON SERIES 500 BACK PLATE.

CONTACT NO.	COLOR	WIRE NO.	TO PLUGS	PLUG CONTACT NO.
1	WHT			
2	WHT.			
3	RED			
4	PINK			
5	GREEN			
6	ORANGE			
7	BROWN			
8	YELLOW			
9	VIOLET			
10	GRAY			
11	WHITE			
12	TAN			
13	YELLOW			
14	GRN/W			
15	BLK/W			
16	RED/W			
17	BLUE/W			
18	BROWN/W			
19	VIOLET/W			
20	DRG/W			
21				
22				
23				
24				

OPEN

GROUND & L2

BY \_\_\_\_\_ DATE \_\_\_\_\_  
 CHKD. BY \_\_\_\_\_ DATE \_\_\_\_\_  
 SUBJECT: A-3D WIRING  
 RED CABLE  
 A-4918-5  
 491870A  
 SHEET NO. \_\_\_\_\_ OF \_\_\_\_\_  
 JOB NO. \_\_\_\_\_ PLUGS = 5

BY \_\_\_\_\_ DATE \_\_\_\_\_  
 CHKD. BY \_\_\_\_\_ DATE \_\_\_\_\_  
 SUBJECT A-3P WIRING  
 SHEET NO. \_\_\_\_\_ OF \_\_\_\_\_  
 JOB NO. \_\_\_\_\_  
 PLUG #6

CONTACT NO.	CABLE COLOR	WIRE NO.	PLUG TO PLUG CONTACT NO.
1	BLUE	100	9
2	BLACK	101	9
3	RED	102	9
4	PINK	103	9
5	GRAY	104	9
6	ORANGE	105	9
7	BROWN	106	9
8	YELLOW	107	9
9	VIOLET	108	9
10	GRAY	109	8
11	WHITE	110	4
12	TAN	111	4
13	YEL/W	112	13
14	GRN/W	113	13
15	BLK/W	114	13
16	RED/W	115	13
17	BLUE/W	116	13
18	BRN/W	117	13
19	VID/W	118	13
20	ORG/W	119	13
21			
22			
23			
24			

REV. A - 11-7-61  
 REV. B - 11-11-61  
 REV. C - 2-1-62  
 REV. D - 4-2-62  
 REV. E - 5-8-62  
 REV. F - 7-9-63  
 REV. G - 8-8-66  
 REV. H - 10-1-66  
 REV. I - 11-1-66  
 REV. J - 11-1-66  
 REV. K - 11-1-66  
Add. Dwg. No. 4918-5 revised to series 801 with Prime Sky connectors.  
 This sheet same on series 800 Back Plate.

A-491870A

BY \_\_\_\_\_ DATE \_\_\_\_\_  
 CHKD. BY \_\_\_\_\_ DATE \_\_\_\_\_  
 SUBJECT H-32 WIRING 491870A  
 BLACK CABLE  
 JOB NO. \_\_\_\_\_  
 SHEET NO. \_\_\_\_\_ OF \_\_\_\_\_  
 PLUG # 7

WIRE NO.	COLOR	TO	PLUGS	PLUG CONTACT NO.	TERMINAL STRIP CONTACT NO.
120	BLUE	ANNUAL	13	2	BLANK ON A-3
121	BLACK	MOTION-GRND	13	3	BLANK ON A-3
122	RED	TIE-IN	9	15	
123	PINK	GEO. EARTH	9	19	
124	GREEN	TWILIGHT	9	6	
125	ORANGE	SPARE AXIS 3 MOTOR	2/0	6	
126	BROWN	AXIS 3 MOTOR LIM. SW.	2-CH 2/0	19 (17) 7	
127	YELLOW	<del>CARDINAL POINTS</del> AXIS 3 MOTOR FLD.	19 (17) 2/0	19 (17) 7	
128	GRAY	SEXTANT	9	9	6V "U" REG
130	WHITE	LAT	9	17	
131	TAN	MERID.	9	18	
132	YEL/W	SPARE	9	20	
133	GRN/W	ZENITH	9	21	
134	BRN/W	Δ	9	21	
135	RED/W	Δ	9	21	
136	BLUE/W	Δ	9	21	
137	BRN/W	Δ	9	23	
138	VIOL/W	SAT. LAMP	9	24	
139	ORGE/W	SAT. MOTOR	9	22	
21	BRN/W				
22					
23					
Add. Dwg. No. 4918-5 revised to series 801 with Prime Sky connectors.  
 This sheet same on series 800 Back Plate.

REV 7-10-12-65  
 REV. A-11-7-61  
 REV. B-11-9-61  
 REV. C-2-1-62  
 REV. D-4-2-62  
 REV. E-5-8-62  
 REV. F-7-9-62  
 REV. G-8-8-62  
 REV. H-11-9-62  
 REV. I-11-11-62  
 REV. J-11-11-62  
 REV. K-11-11-62  
AXIS 3  
 PLUG 3/0  
 PLUG 2/0  
 1  
 2  
BY DATE SUBJECT H.S.F. WIRING GREEN CABLE 4918704  
 CHKD. BY DATE JOB NO. PLUG # 8  
 SHEET NO. OF

TERMINAL	WIRE NO.	COLOR	TO PLUGS	PLUG CONTRACT NO.	STRIP CONTRACT NO.
1 BLUE	190				
2 BLACK	191				
3 RED	192				
4 PINK	193				
5 GREEN	194				
6 ORANGE	195				
7 BROWN	196				
8 YELLOW	197				
9 VIOLET	198				
0 GRAY	199				
1 WHITE	200				
2 TAN	201				
3 YELLOW	202				
4 GREEN/W	203				
5 BLACK/W	204				
6 RED/W	205				
7 BLUE/W	206				
8 BROWN/W	207				
9 VIOLET/W	208				
0 ORANGE/W	209				
1					
2					
3					
4					
5					
6					
7					
8					
9					
0					
1					
2					
3					
4					
5					
6					
7					
8					
9					
0					

Added Dwg. No. A-4918-5, revised 307 Prime Sky connectors for series 801 Back Plate. Pin #12 and 13 was to Plug 9, Pin 31.

REV. D-11-7-61  
 REV. E-11-3-61  
 REV. D-5-3-62  
 REV. 5-1-63  
 REV. 6-8-66  
 A-4918704

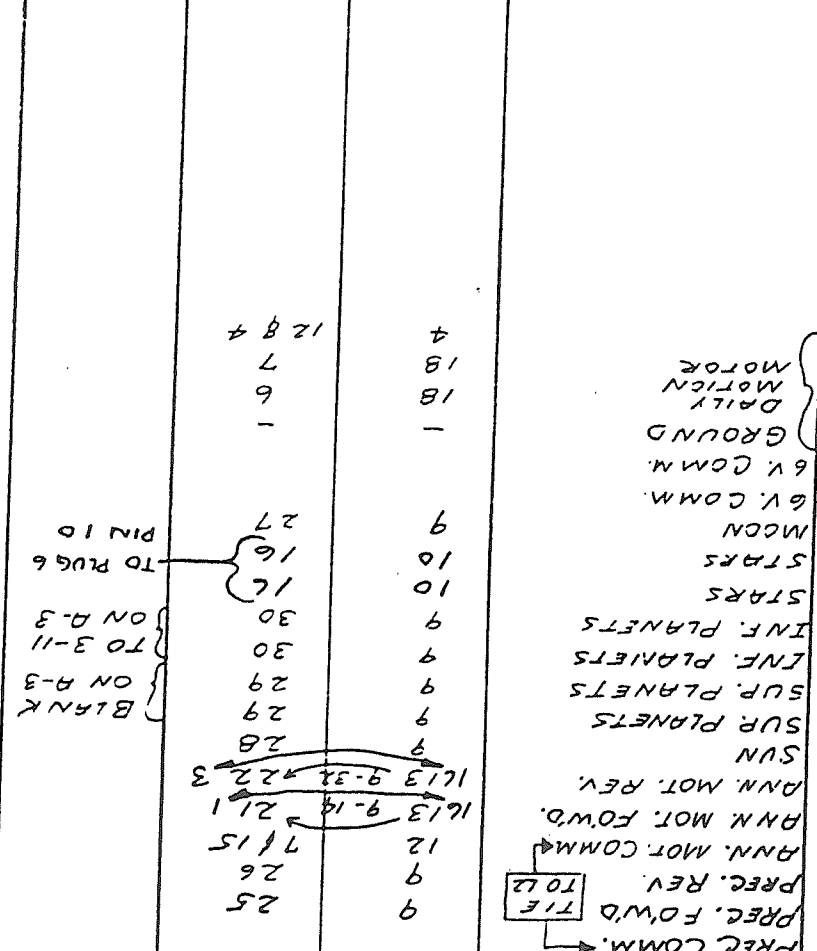

BY \_\_\_\_\_ DATE \_\_\_\_\_  
 CHKD. BY \_\_\_\_\_ DATE \_\_\_\_\_  
 SUBJECT: H-3F WIRING PANEL "C" 491870A  
 SHEET NO. \_\_\_\_\_ OF \_\_\_\_\_  
 JOB NO. \_\_\_\_\_  
 PLUG # 9

CONTACT NO.	HARNES COLOR	TO PLUGS	PLUG CONTACT NO.	TERMINAL STRIP CONTACT NO.
1		6	6	
2		6	7	
3		3	8	
4		10	1	
5		20	8	
6		3	16	
7		3	16	
8		3	16	
9		3	16	
10		3	12 & 13	
11		13	14	BLANK ON A-3
12		6	1	
13		6	2	
14		6	5	
15		6	19	
16		6	14	
17		6	11	
18		7	12	
19		7	5	
20		7	14	
21		7	15, 16, 17, 18	
22		7	21	
23		7	19	
24		7	20	
25		8	2	
26		8	3	
27		8	14	
28		8	7	
29		8	8	
30		8	14	
31		10	8 & 9	BLANK ON A-3
32		10	10 & 11	BLANK ON A-3

MOON PHASING  
 KEY SWITCH PL-1 TO POWER SUPPLY  
 STAR - FUSE  
 SIGNAL  
 +6V. DC CLOCK  
 -6V. DC CLOCK GRND.  
 6V. UNREGUL.  
 6V. REG.  
 +45V. DC  
 EQL. LAMP  
 COORD. LAMP  
 MOON PHASING  
 GEO. EARTH  
 POLE  
 LATITUDE  
 MERIDIAN  
 TWILIGHT  
 ZENITH  
 TRIANGLE  
 CARD. PTS.  
 SATELLITE LAMP  
 SAT. MOTOR  
 PREC. F.W.D.  
 PREC. REV.  
 MOON  
 SUN  
 SUP. PLANETS  
 INF. PLANETS  
 STARS - FUSE  
 MOON PHASING

ADDED DWG. NO. 4918-5 AND REVISED FOR PRIME SKY SERIES 801 BACK PLATE, PIN 5 WAS TO PLUG #6, PIN 10 PIN 31 WAS TO PLUG 8, PIN 12 & 13.  
 ADD CONTACT ON BACK PLATE APPROX. 1/4" FROM #32  
 100C-  
 400C-  
 REV. C-2-1-52  
 REV. D-4-2-52  
 REV. E-1-28-51  
 REV. F-7-9-52  
 REV. G-3-11-53  
 REV. H-11-7-54  
 REV. I-3-3-54  
 A-491870A

BY \_\_\_\_\_ DATE \_\_\_\_\_  
 CHKD. BY \_\_\_\_\_ DATE \_\_\_\_\_  
 SUBJECT: A-3P WIRING  
 STANDARD STARS AT RIME  
 A 4918704  
 SHEET NO. \_\_\_\_\_ OF \_\_\_\_\_  
 JOB NO. \_\_\_\_\_  
 Plug # 10

CONTACT NO.	COLOR	WIRING NO.	STAR FUSE	STAR FUSE	PLUG CONTACT NO.
1			STAR FUSE	9	5
2			STAR FUSE	9	31
3					
4					
5					
6					
7					
8				11	6
9				11	5
10				GROUND	12 & 13
11				110V	7 2
12				11	1
13				11	2
14				11	3
15				11	4
16				8	12 & 13

Add Plug #11 to take care of Prime Sky and Series 601 back plate.

REV. 5, 7-9-63  
 R.E.O. 6, 8-8-66  
 A-4918704

8 7 6 5 4 3 2 1  
 CONTACT NO.

COLOR

WIRE NO

CONTACT NO.	COLOR	WIRE NO	TO PLUG	PLUG CONTRACT NO.
1			10	12
2			10	13
3			10	14
4			10	15
5			10	8
6			10	7
7			10	—
8			10	—

Add Plug #11 to take care of Prime Sky and Series 801 Back Plate.

Rev. 6, 7-17-63. Pln 5 was to Plug 10 - Pln 7  
 Pln 6 was to Plug 10 - Pln 7

REV 6 8-9-66  
 Rev. 5, 7-9-63  
 A-491870A

SHEET NO. \_\_\_\_\_ OF \_\_\_\_\_  
 JOB NO. \_\_\_\_\_  
 Plug #11

SUBJECT: A3P WIND F  
 STANDARD OR POINT STAR  
 CONTROL Plug  
 A 491870A

BY \_\_\_\_\_ DATE \_\_\_\_\_  
 CHKD. BY \_\_\_\_\_ DATE \_\_\_\_\_

Cable No. 16  
15  
14  
13  
12  
11  
10  
9  
8  
7  
6  
5  
4  
3  
2  
1

Cable Color	To Plug	Contract #
BLU	NO CONTACTS RY1A	13
BLU	NC "	13
—	GROUND	—
GRN	NO CONTACTS RP-1B	13
GRN	NC "	13
RED	TO ANNUAL-DAILY TIE-IN	13
—	GROUND	—
BLK	TO ANNUAL-DAILY TIE-IN	13
—	—	24

OPPOSITE PINS JUMPERED

Add. Dwg. No. 4918-5 revised to series 801 with Prime Sky connectors. This sheet same on series 800 Back Plate.

REV 7 8-8-66

REV: D TO ACCOMMODATE  
SERIES 400C  
SPEED CHASSIS  
4-2-62  
REV: E 5-8-62  
SERIES 500  
A-491870A

BY: DATE: 26-9501-16S  
CHKD. BY: DATE: 26-9401-16P  
SUBJECT: A3P WIRING  
TRAUSEFORMER CHASSIS  
SERIES 500  
A-491870A  
JOB NO. PLUG #  
SHEET NO. OF

SHEET NO. \_\_\_\_\_ OF \_\_\_\_\_  
 JOB NO. \_\_\_\_\_  
 PLUG #13

SUBJECT: A-3P WIRING  
 ANNUAL MOTION SPEED  
 A-91870A  
 SERIES 400G

DATE \_\_\_\_\_  
 CHKD. BY \_\_\_\_\_  
 26-4501-285  
 26-4401-242

CONTACT NO.	CABLE COLOR	TO PLUG NO.	CONTACT NO.
1	RED	-	-
2	VIO.	7	1
3	VIO/W	7	3
4	BRN	17	1
5	BRN/W	17	2
6	GRY/W	17	3
7	BLK/W	17	4
8	BLK	17	5
9			
10			
11			
12	YEL	17	6
13	PINK	9	11
14	BLU	12	1
15	BLU/W	12	2
16	GRN	12	4
17	GRN/W	12	5
18	WHT		
19	AM OUT	(9) 8 (16)	5 (11) (4)
20	AM IN	12	6
21	AM OUT	12	6
22	AM IN	12	6
23	AM IN	12	5

Add. Dwg. No. L918-5 revised to series 501 with Prime Sky connectors.  
 This sheet same on series 500 Back Plate.

REV. D-4-2-62  
 REV. E-5-8-62  
 REV. 5, 7-9-63  
 REV. 6, 8-8-67

A-491870A

REV D 400C - A.M. SYSTEM 9-2-62  
 REV C 100C - DM/KH " 9-2-62  
 Rev. 5, 7-9-63  
 Rev. 6, 8-6-66 A-491870A

Add. Dwg. No. 4918-5 revised to series 801 with Prime Sky connectors.  
 This sheet same on series 800 Back Plate.

8	BLK																		
9	BLU																		
10	GRN																		
11																			
12																			
13																			
14																			
15																			
16																			

BY: DATE: 26-4501-16P  
 CHKD. BY: DATE: 26-4501-16P  
 SUBJECT: BAP WIRING  
 LATITUDE SWITCH  
 4918-5 491870A  
 SHEET NO. OF: PLUG #15

CABLE  
 ORDER

CONTACT  
 #

BY DATE  
 CHKD. BY DATE 26-501-82  
 26-4401-85

SUBJECT B-32 WIRING  
 ANNUAL MOTION INDICATOR  
 JOB NO. 491870A  
 SHEET NO. OF PLUG #15

CONTACT NO.  
 1  
 2  
 3  
 4  
 5  
 6  
 7  
 8

CONTACT NO.	CABLE COLOR	TO PLUG	TO CONTACT NO.
1	RED/W	13	21
2	WHT	-	-
3	BLK/W	13	22
4	AM OUT		
5	GROUND		
6	AM OUT		

Add. Dwg. No. 4918-5 revised to series 801 with Prime Sky connectors.  
 This sheet same on series 800 Back Plate.

REV.-D - TO ACCOMMODATE  
 SERIES 4000  
 ANN MOT. SYSTEM  
 Rev. 5, 7-9-63  
 REV. C 8-8-66  
 A-491870A



A-491870H

REV. D - ACCOMMODATE  
 SERIES 400C  
 GEN. MOT. SYSTEM  
 REV. 5, 7-9-63  
 REV. C, 8-8-66

Add. Dwg. No. 4918-5 revised to series 901 with Prime Sky connectors.  
 This sheet same on series 800 Back Plate.

CONTRACT NO.	TO PLUS CONTRA	CABLE COLOR	NO.
1	13	PINK	4
2	13	RED	5
3	13	YEL	6
4	13	FORWARD	7
5	13	REVERSE	8
6	13	F & R	13
7	13	AM - ON/OFF	13
8	18	TIE-IN	8
9	9 (18)	6 V. AC	9 (9)

BY \_\_\_\_\_ DATE \_\_\_\_\_  
 26-4501-16P  
 26-4401-165  
 CHKD. BY \_\_\_\_\_ DATE \_\_\_\_\_  
 26-4501-16P  
 26-4401-165  
 SUBJECT: 4-3P WIRING  
 ANNUAL MOTION SWITCH  
 SERIES 400C  
 4-1078-  
 491870H  
 SHEET NO. \_\_\_\_\_ OF \_\_\_\_\_  
 JOB NO. \_\_\_\_\_  
 PLUG #17



BY \_\_\_\_\_ DATE \_\_\_\_\_  
 CHKD. BY \_\_\_\_\_ DATE \_\_\_\_\_  
 SUBJECT A-3P WIRING  
~~PLUG #19~~ PLUG #19  
 SHEET NO. \_\_\_\_\_ OF \_\_\_\_\_  
 JOB NO. \_\_\_\_\_

CONTRACT NO.	WIRE NO.	COLOR	TO PLUGS	PLUG NO.	TERMINAL
1		RED			
2		WHITE			
3		BROWN			
4		ORG/W			
5		BLK			
6		YEL.			
7		BLU			
8		GRN			
9		VID			
10		RED/W			
11		PANEL LITE			
12		#10 RIP			
13		BLK/W			
14		SW-1 110V AC			
15		YEL/W			
16		BLU/W			
17		GRN/W			
18		VID/W			
19		BLK/W			
20		YEL/W			
21		BLU/W			
22		GRN/W			
23		VID/W			
24		BLK/W			

Add. Dwg. No. 4918-5 revised to series 801 with Prime Sky connectors.  
 This sheet same on series 800 Back Plate.

REV. A-11-7-61  
 REV. B-11-8-61  
 REV. C-2-1-62  
 REV. D-5-8-62  
 REV. E-7-9-63  
 REV. F-8-8-62

A-491870A

BY DATE \_\_\_\_\_  
 CHECKD BY DATE \_\_\_\_\_  
 SUBJECT A-3P WIRING  
READING LAMP  
~~TEST~~ 491870A  
 JOB NO. PLUG #20  
 SHEET NO. \_\_\_\_\_ OF \_\_\_\_\_

CONTACT NO.	COLOR	WIRE NO.	TO PLUGS	CONTACT NO.
1	ORG/W	214	2	5
2	GRY	212		
3				
4				
5	RED/W		19	13
6	WHITE			
7	RED			
8				
9			9	6
10				
11				
ADD. DWG. NO. 4918-5 REVISED TO SERIES 801 WITH PRIME SKY CONNECTORS.  
 THIS SHEET SAME ON SERIES 800 BACK PLATE.

REV. A - 11-7-61  
 REV. B - 11-8-61  
 REV. C - 2-1-62  
 REV. D - 7-9-63  
 REV. E - 8-8-66  
 REV. F - 11-8-70A

BY: R. DATE: \_\_\_\_\_  
 CHKD. BY: \_\_\_\_\_ DATE: \_\_\_\_\_  
 SUBJECT: A3 & A3P WIRING BACKPLATE  
 SHEET NO. 21 OF 21  
 JOB NO. PH, L1, L2  
 A-491870-A

WIRE COLOR	USE	PLUG	PIN	REMARKS
RED/W	PL1 AC INPUT	0 3 9	1,2,3,4 8 3	Clock
	L1	2 3 4 6 9 10 13 19	1 6 2 11 4 11 1	FUSED
WHITE	L2 OR GROUND OR COMMON	0 1 2 3 4 5 6 7 8 9 10 12 13 15 18	5,6,7,8 2,6 2 12,5,7,9,10 1,9 1,2 5,12,13, 15,17 2,10 1,4,15 1,6,17 8, 10 3,11,7,15 13 15 18	CONT'D. PLUG 19 20 16 PIN 2 2,6 2,6

Added Dwg. No. A-4918-5 revised for Series 801 Back Plate for Prime Sky. Added L1 to Plug 10, Pin 11. Added L2 to Plug 10, Pin 10.

REV 6, 8-8-66  
 REV. 5, 7-9-63  
 A-491870-A